

AS BUILT GROUND FLOOR PLAN
1:250

AMMENDMENTS:

NOTE:

CHECKER:

CONTENTS:

ECC AS BUILT GROUND FLOOR PLAN

SCALE:

PROJECT:

SEENU HITHADHOO REGIONAL HOSPITAL

CLIENT:

MINISTRY OF HOUSING AND INFRASTRUCTURE

ARCH. DESIGN:

STRUC. DESIGN:

DRAWN BY:

DATE: AUGUST 2002


FILE:

DWG NO:



MINISTRY OF HOUSING & INFRASTRUCTURE
INFRASTRUCTURE DEPARTMENT

AMEENEE MAGU, MAAFANNU, MALE', 20392, REPUBLIC OF MALDIVES
TEL: +960 3004300, FAX: +960 3004301

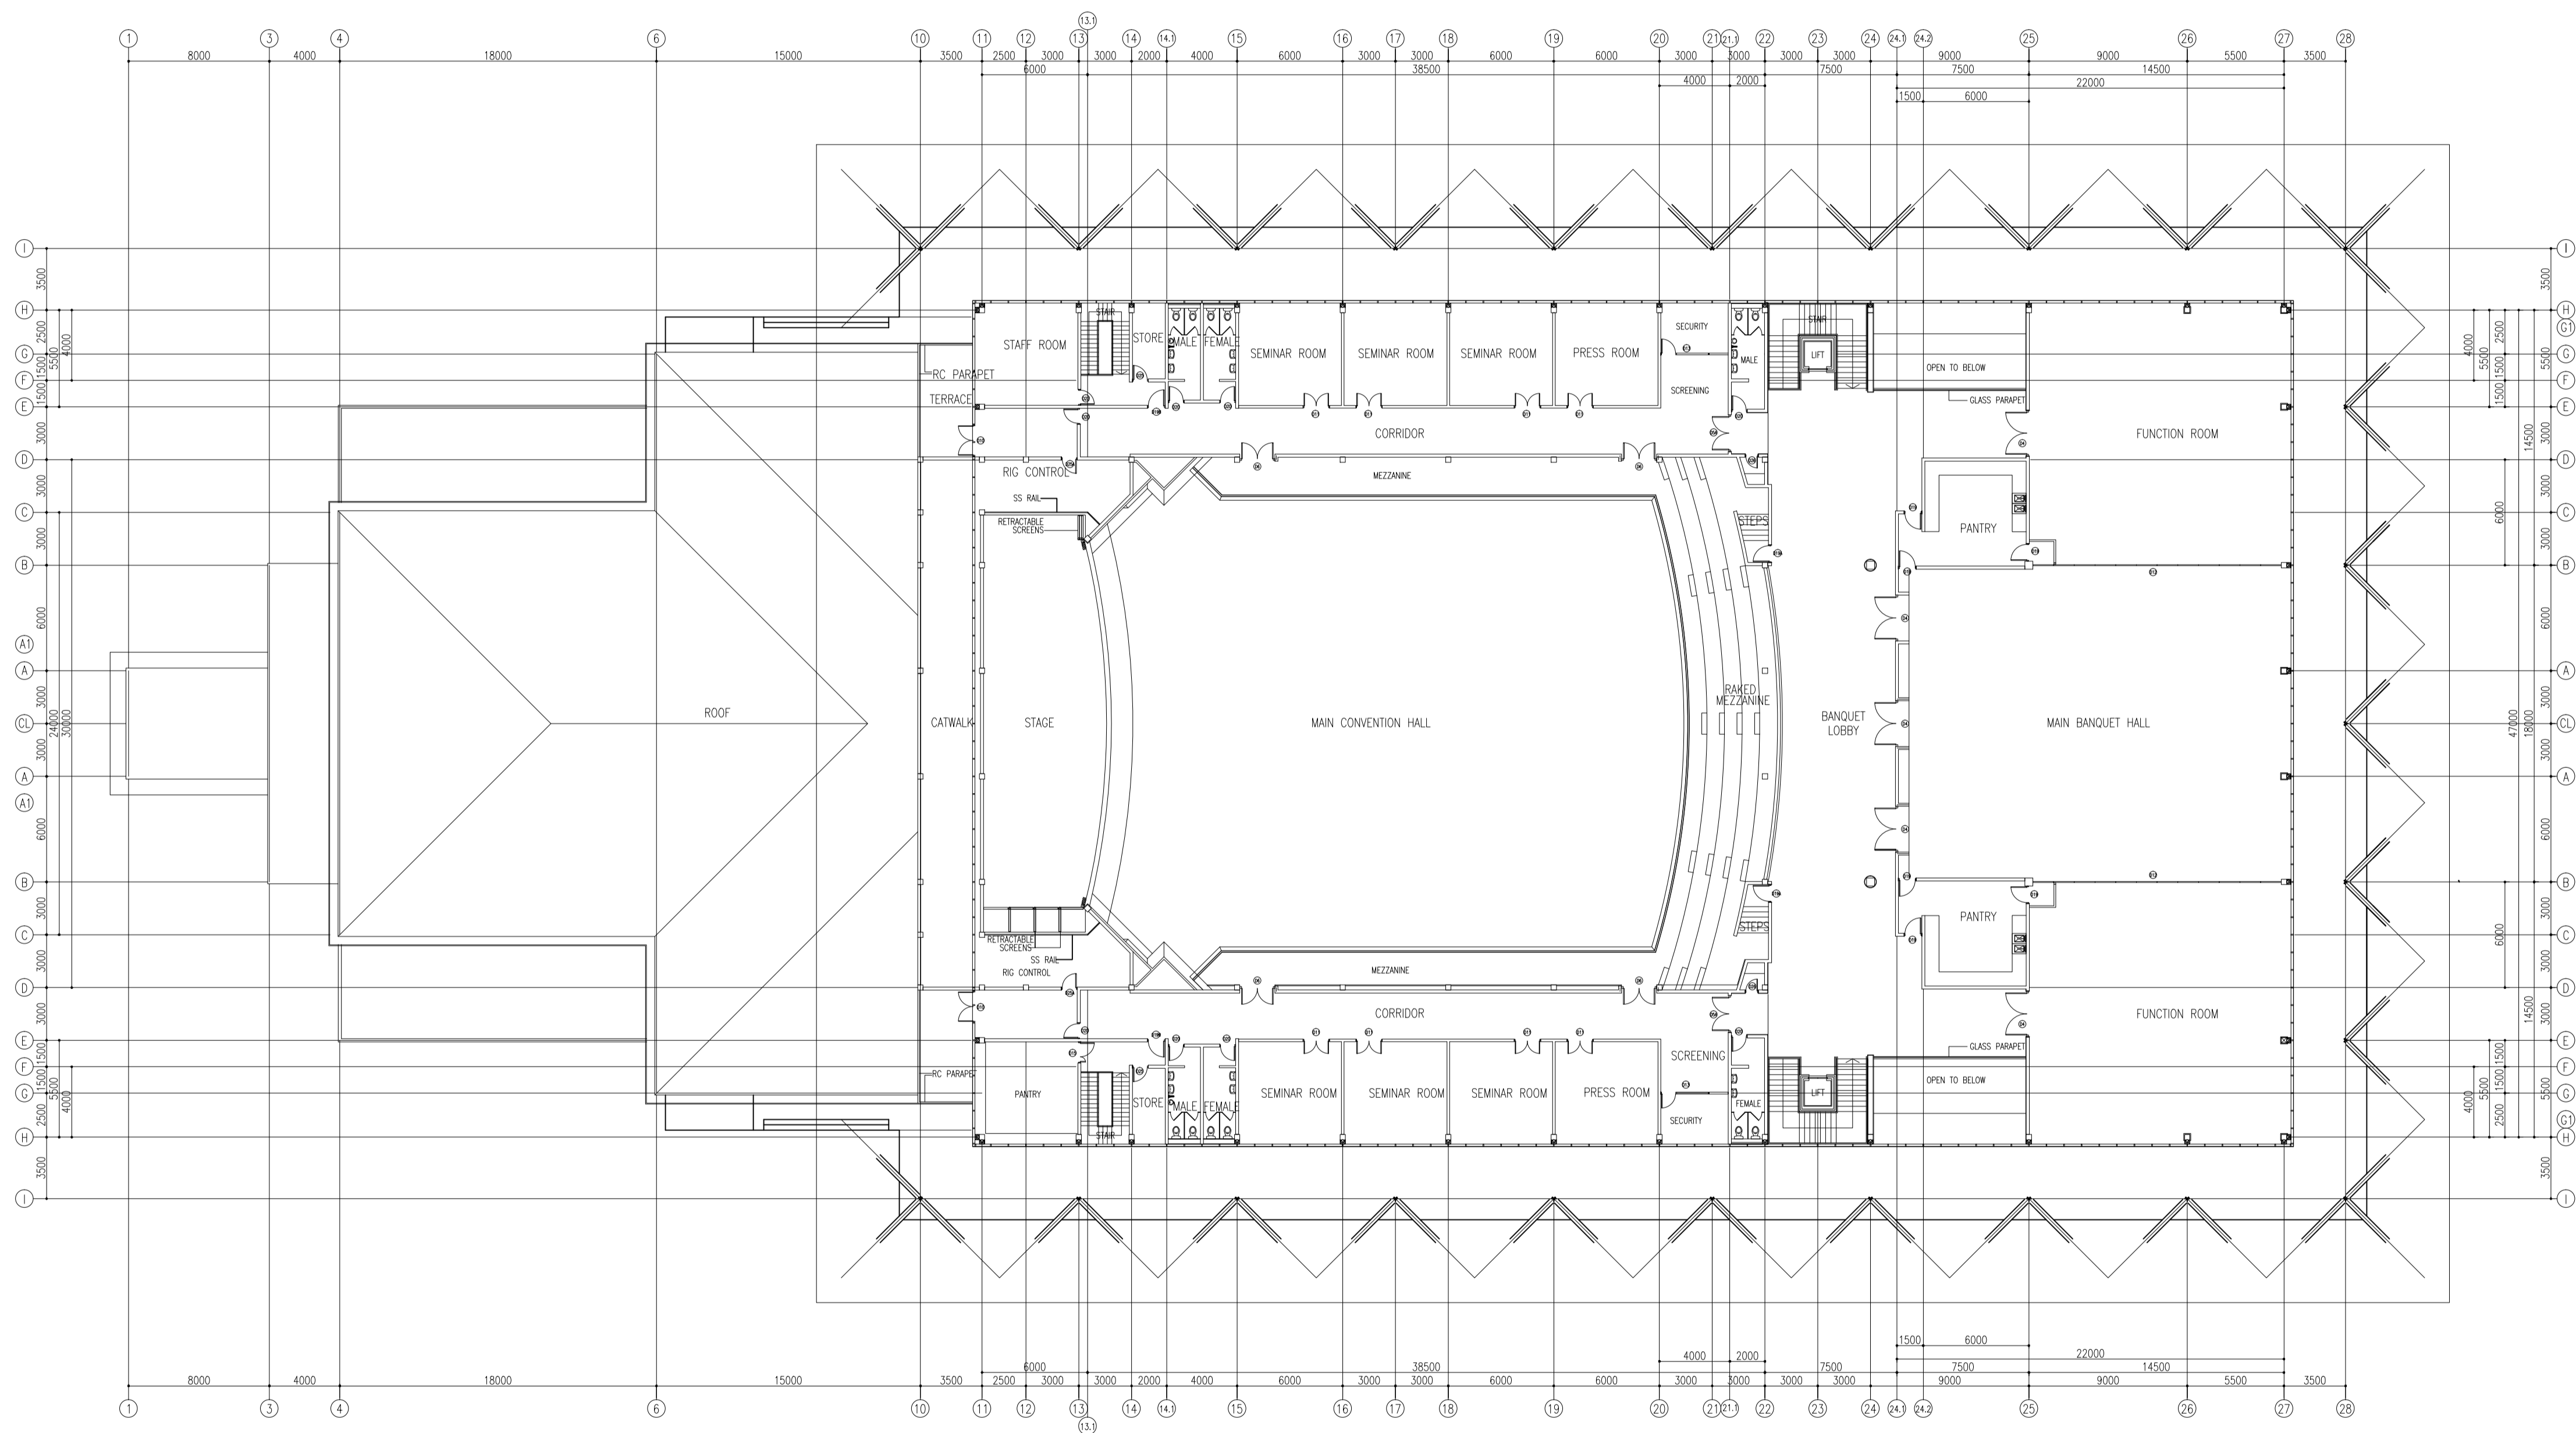

AS BUILT FIRST FLOOR PLAN
1:250

AMMENDMENTS:

NOTE:

CHECKER:

CONTENTS:

ECC AS BUILT GROUND FLOOR PLAN

SCALE:

PROJECT:

SEENU HITHADHOO REGIONAL HOSPITAL

CLIENT:

MINISTRY OF HOUSING AND INFRASTRUCTURE

ARCH. DESIGN:

STRUC. DESIGN:

DRAWN BY:

DATE: AUGUST 2002


FILE:

DWG NO:




MINISTRY OF HOUSING & INFRASTRUCTURE
INFRASTRUCTURE DEPARTMENT


AMEENEE MAGU, MAAFANNU, MALE', 20392, REPUBLIC OF MALDIVES
TEL: +960 3004300, FAX: +960 3004301

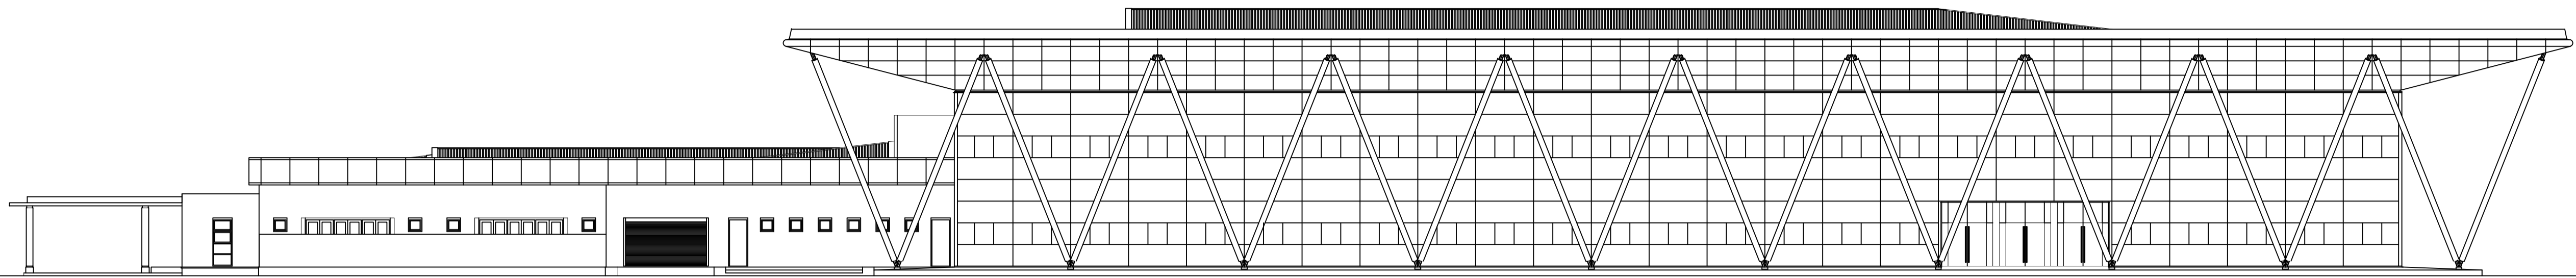

ELEVATION A
1:200

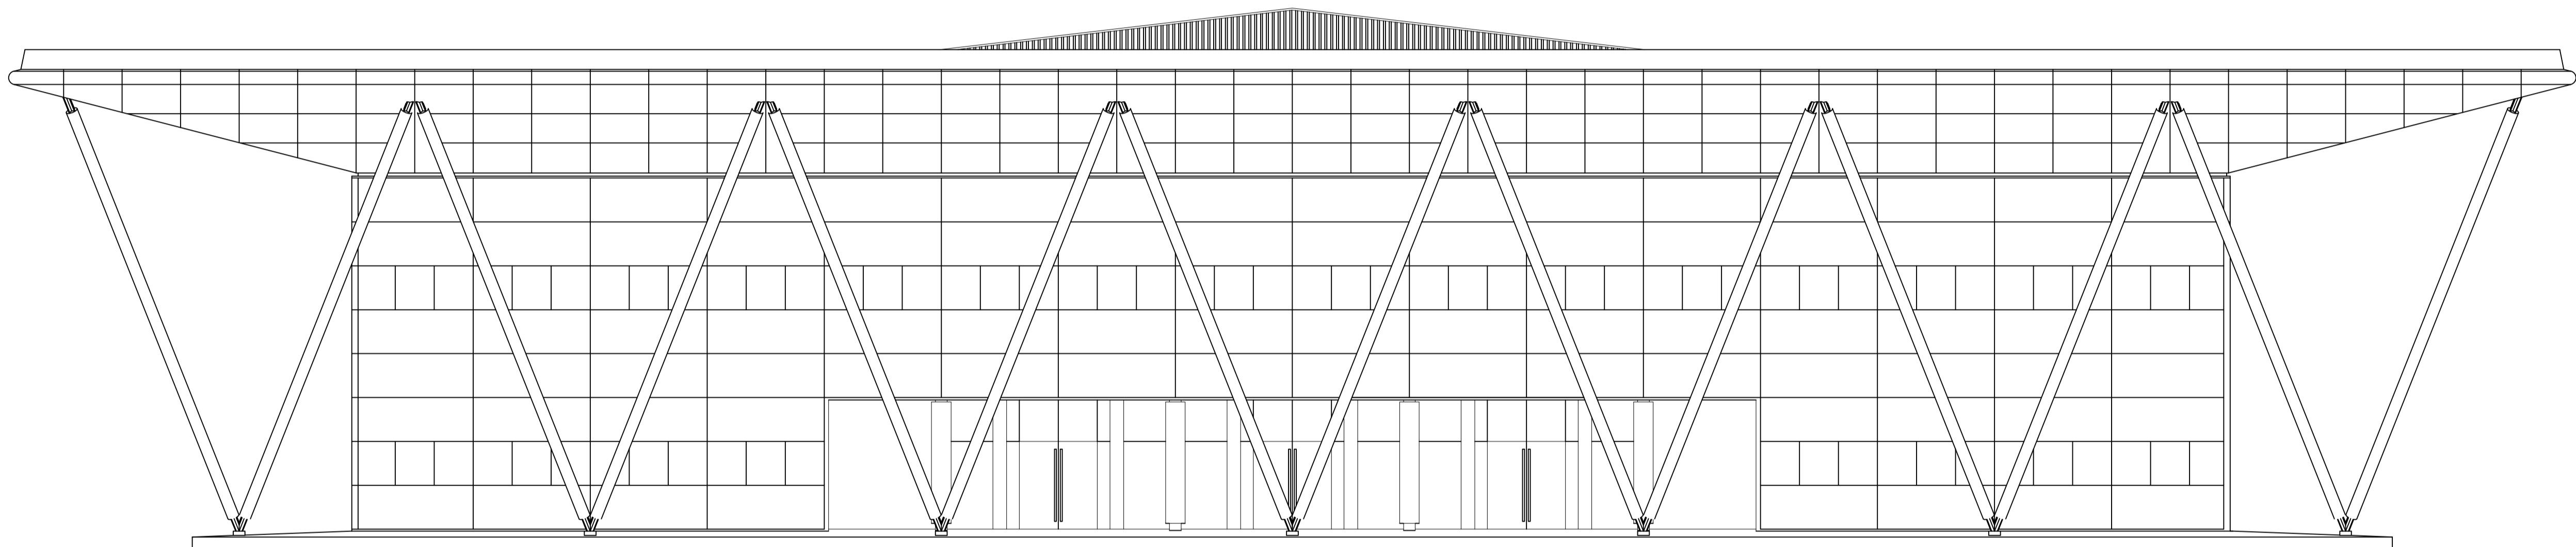

ELEVATION B
1:100

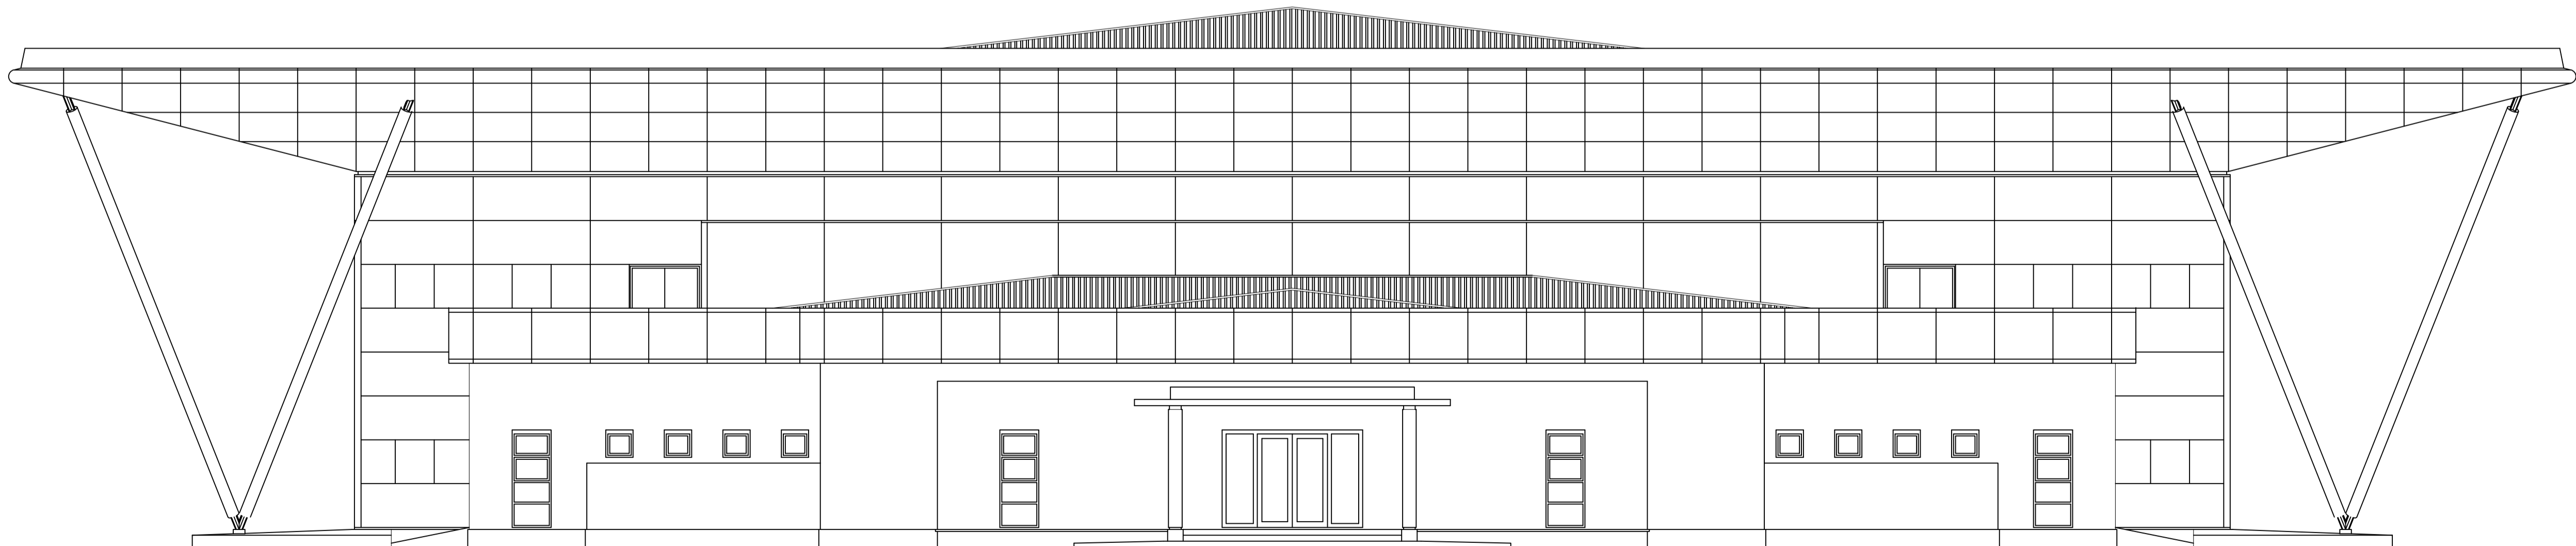

ELEVATION C
1:100

ELEVATIONS

AMMENDMENTS:

NOTE:

CHECKER:

CONTENTS:

ELEVATIONS

SCALE:

PROJECT:

SEENU HITHADHOO REGIONAL HOSPITAL

CLIENT:

MINISTRY OF HOUSING AND INFRASTRUCTURE

ARCH. DESIGN:

STRUC. DESIGN:

DRAWN BY:

DATE: AUGUST 2002

FILE:

DWG NO:



MINISTRY OF HOUSING & INFRASTRUCTURE
INFRASTRUCTURE DEPARTMENT
AMEENEE MAGU, MAAFANNU, MALE*, 20392, REPUBLIC OF MALDIVES
TEL: +960 3004300, FAX: +960 3004301