



(AGL PANEL)
CL:65kW
MD:65kW

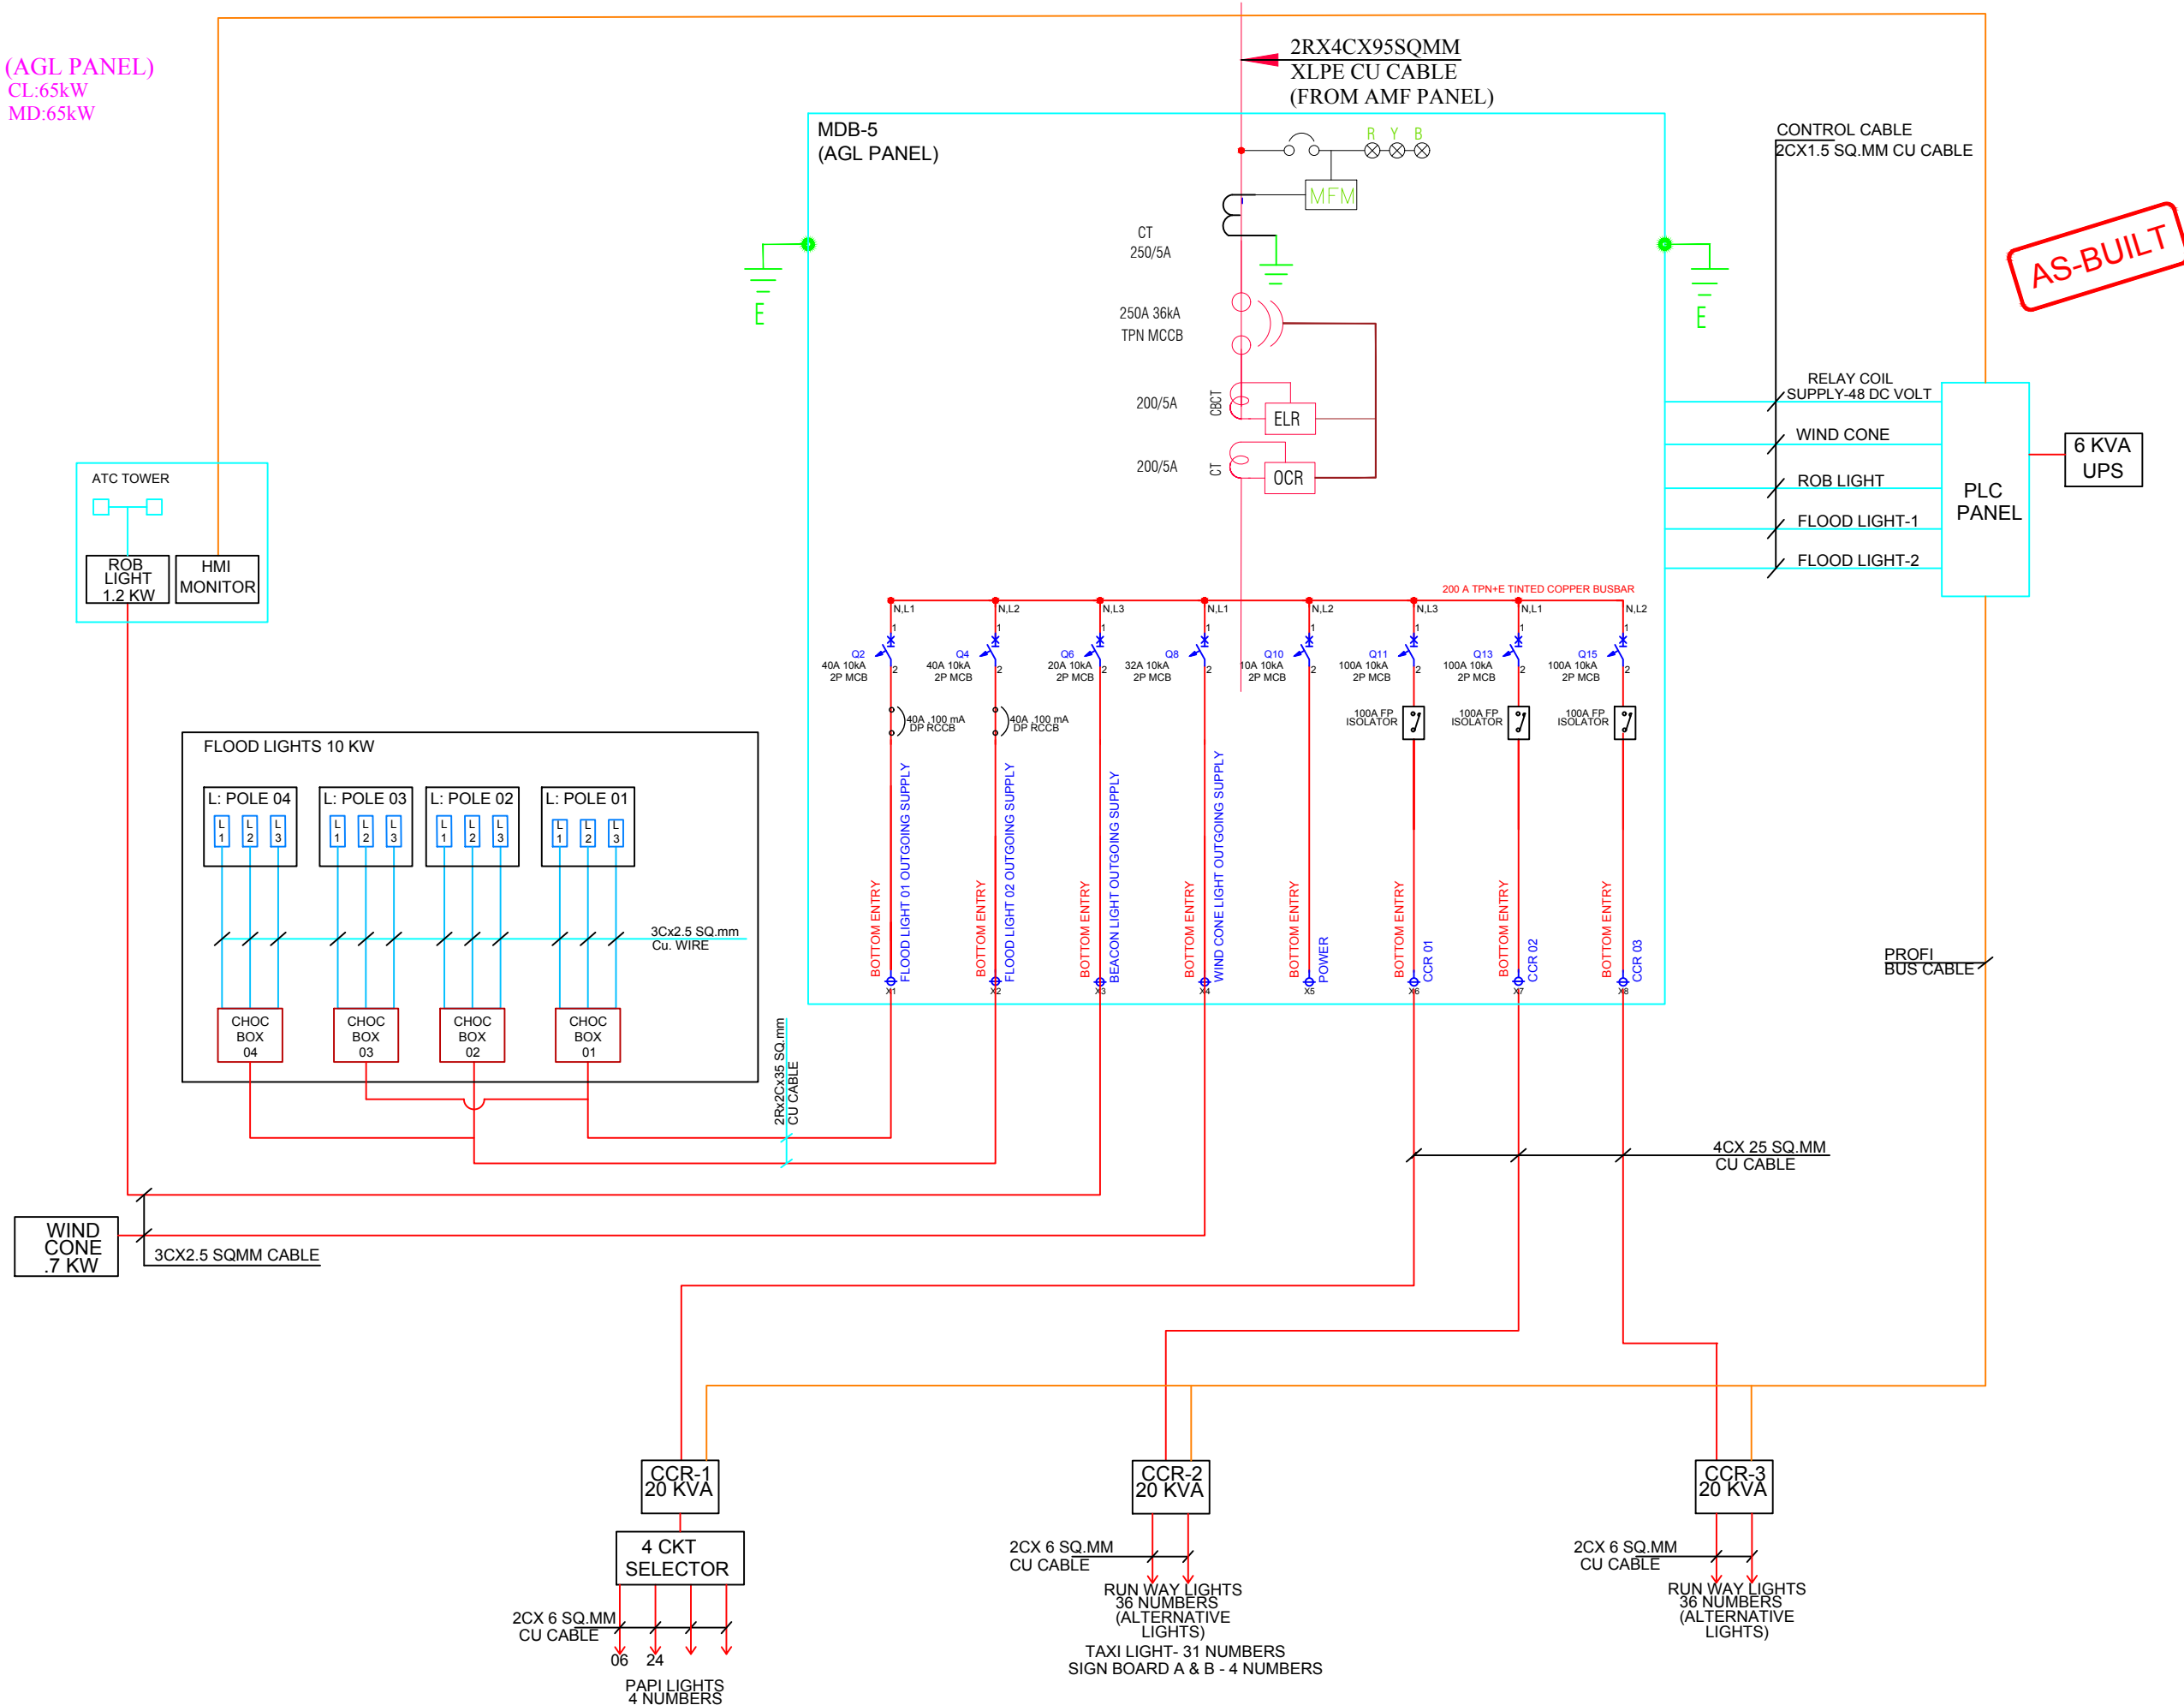

KEY PLAN

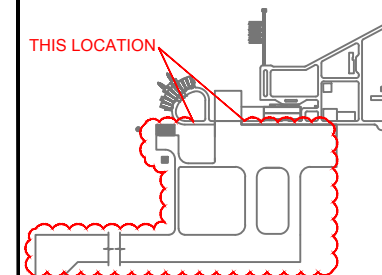

M. PRABHU
CONSULTANT SIGNATURE

19-08-2019
DATE

APPROVAL OF REGIONAL AIRPORT
MALDIVES

DATE

REFERENCE CONSTRUCTION DRAWING NUMBER
T1713-TOS-33000-CV-DW-0028

REV
A4

AS-BUILT

Description
AS-BUILT

Date
19/08/2019

DRAWING STATUS
APPROVED
REJECTED

N. MAAFARU AIRPORT AIRFIELD LIGHTING & LANDING AIDS

Drawing Title:
AGL SCHEMATIC

Employer:
REGIONAL AIRPORTS
MINISTRY OF TOURISM

Funder:

صندوق أبوظبي للتنمية
ABU DHABI FUND FOR DEVELOPMENT

Contractor:
 **TUFF**

Consultant:
 **HOCHTIEF
INDIA**

Supervision & Management Consultant:
 **ARMSTRONG**

Issue: AB Date: AUG-2019 Pages: 28 of 38

Scale: N.T.S Paper: A3

DWG #: T1713-TOS-33000-CV-DW-0028